

**CDS MODEL PSW70.70**  
**26.0 CFS CAPACITY**  
**STORM WATER TREATMENT UNIT**  
 (SEE SHEET NO. 3 FOR LOCATION)



AS-BUILT  
 11/26/12

**DIG ALERT**

SECTION 4216/4217 OF THE GOVERNMENT CODE REQUIRES A DIGALERT IDENTIFICATION NUMBER BE ISSUED BEFORE A "PERMIT TO EXCAVATE" WILL BE VALID. FOR YOUR DIGALERT I.D. NUMBER CALL UNDERGROUND SERVICE ALERT TOLL FREE TWO WORKING DAYS BEFORE YOU DIG.

1-800-422-4133

CAUTION: REMEMBER THAT THE USA CENTER NOTIFIES ONLY THOSE UTILITIES BELONGING TO THE CENTER. THERE COULD BE OTHER UTILITIES PRESENT AT THE WORK SITE. THE CENTER WILL INFORM YOU OF WHOM THEY WILL NOTIFY.

**BENCHMARK**


BENCHMARK NO. = CG 3733  
 ELEVATION = 519.40 FT

ROAD DEPARTMENT TAG IN WESTERLY CURB 5 FEET SOUTH OF BCR, 78 FEET NORTH AND 42 FEET WEST OF CENTERLINE INTERSECTION OF VALLEY BOULEVARD AND LEMON AVENUE.

Δ	DATE	DESCRIPTION	APP'D	DATE
REVISIONS				

CITY OF WALNUT

APPROVED BY: *David Gilbertson* 10/19/06  
 DAVID GILBERTSON DATE  
 CITY ENGINEER - RCE 46624

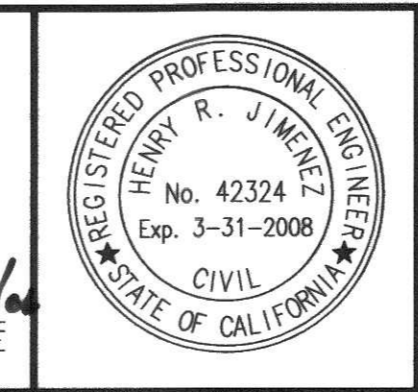

PREPARED BY:

**MDS CONSULTING**

17200 Buell Ave.  
 Suite 300  
 Irvine, CA 92614  
 Phone: 949-251-0201  
 FAX: 949-251-0216

PLANNERS ENGINEERS SURVEYORS


*Henry R. Jimenez* 10-19-06  
 HENRY R. JIMENEZ R.C.E. 42324 DATE

**STORM DRAIN PLANS**


TRACT No. 50867  
**STORM DRAIN LINE "A"**  
 CDS MODEL PSW70\_70  
 LOCATION 1  
 CITY OF WALNUT

187U


SHEET  
**21**  
 OF  
**24**  
 SHEETS

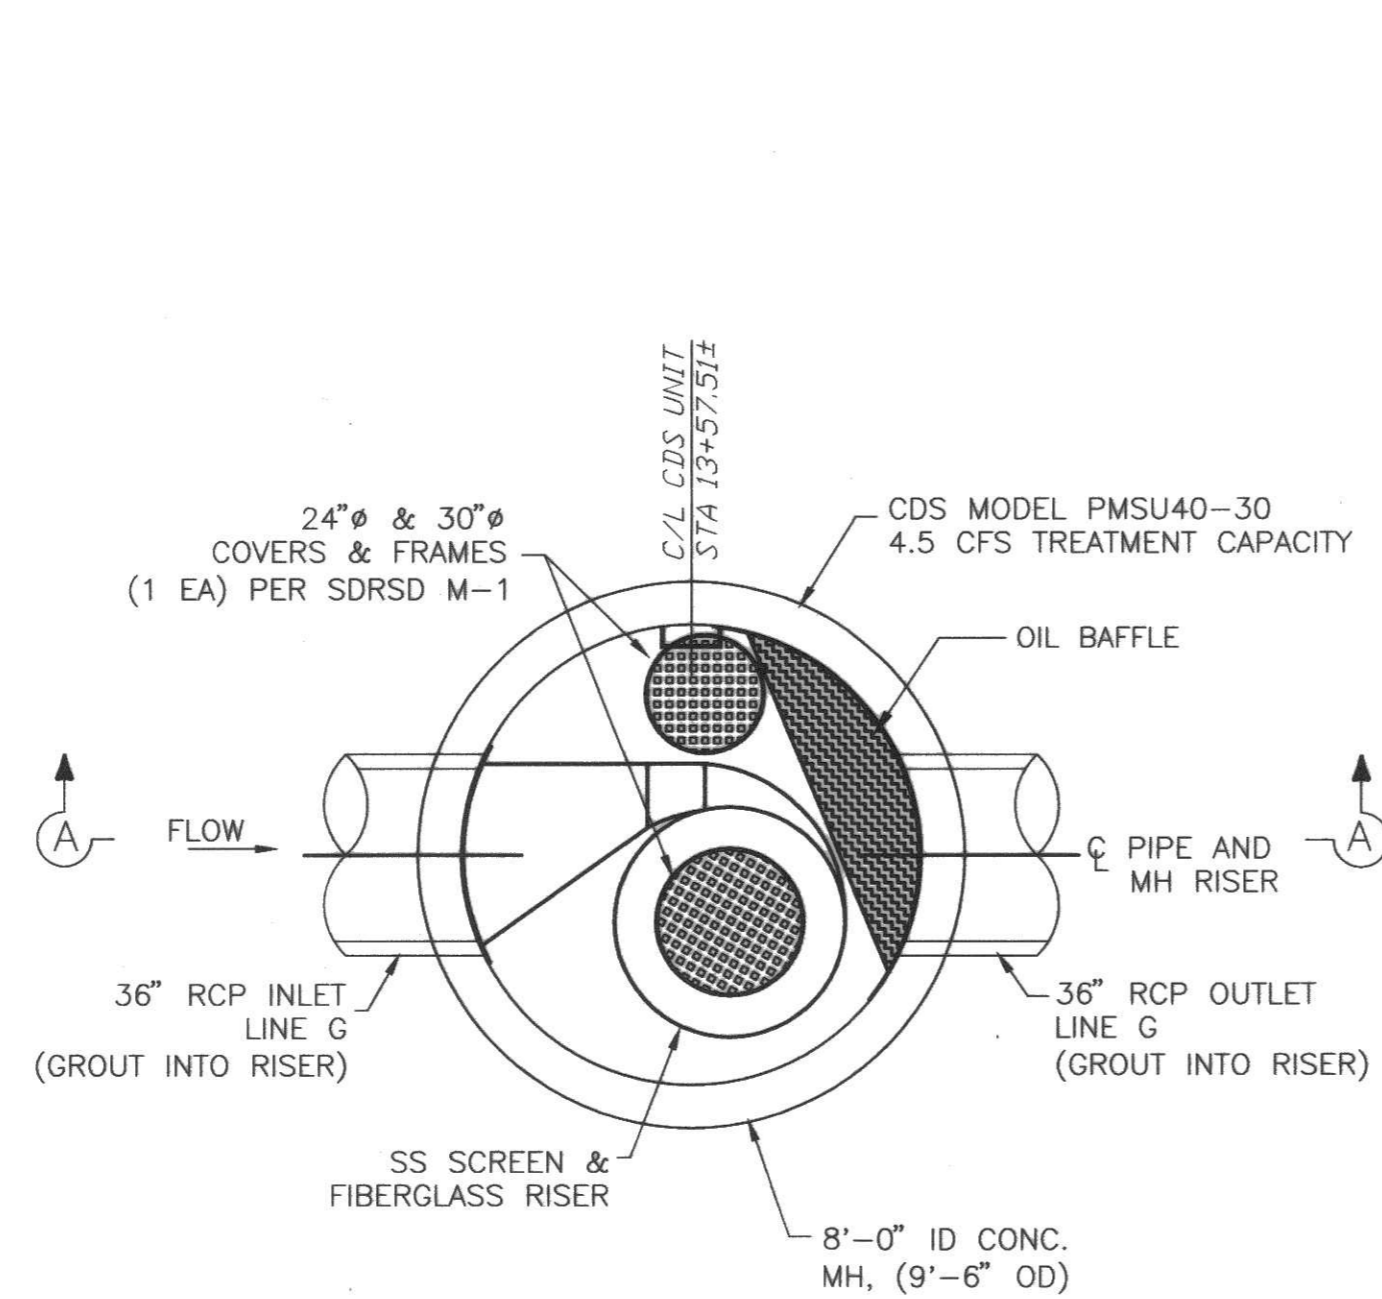

PMSU40-30 TOP PLAN VIEW

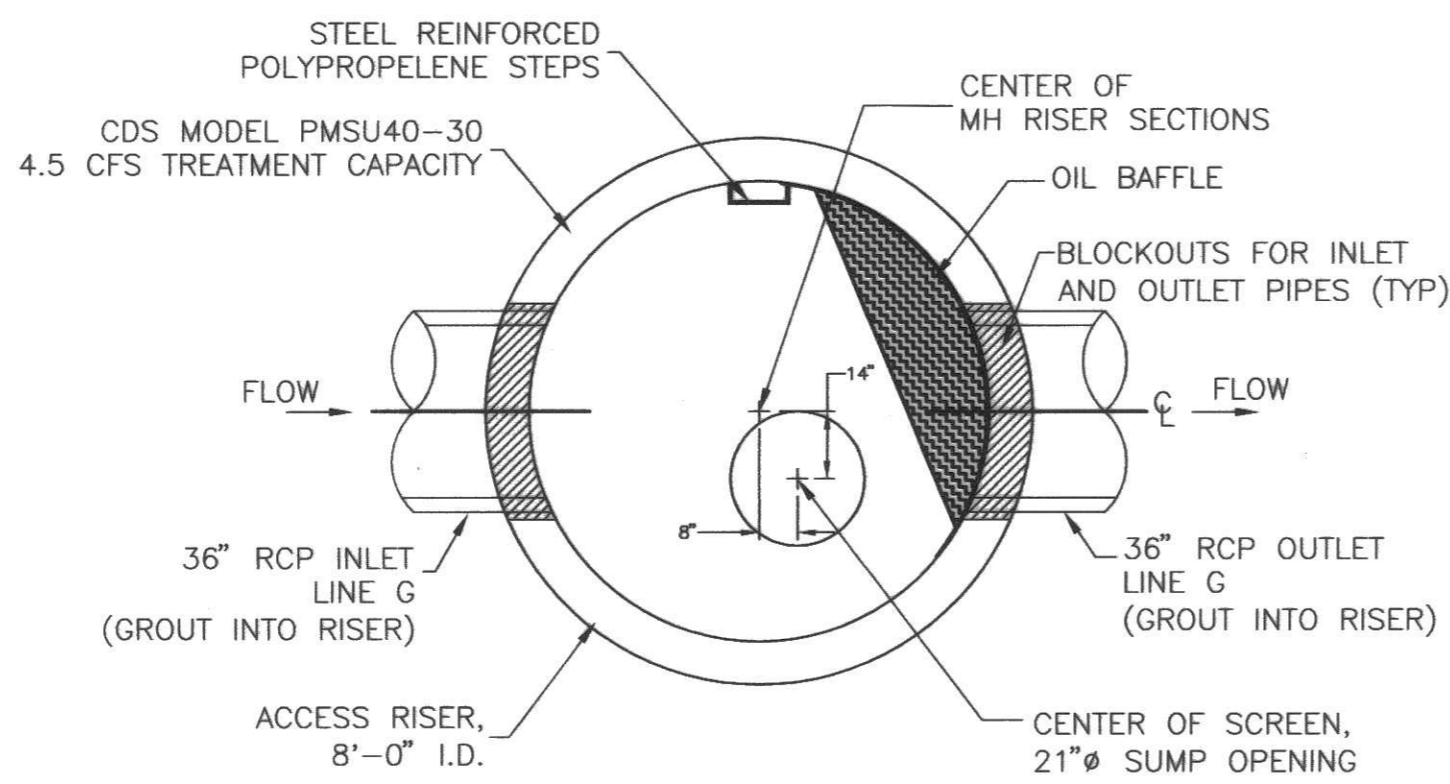

SEPARATION SLAB PLAN VIEW

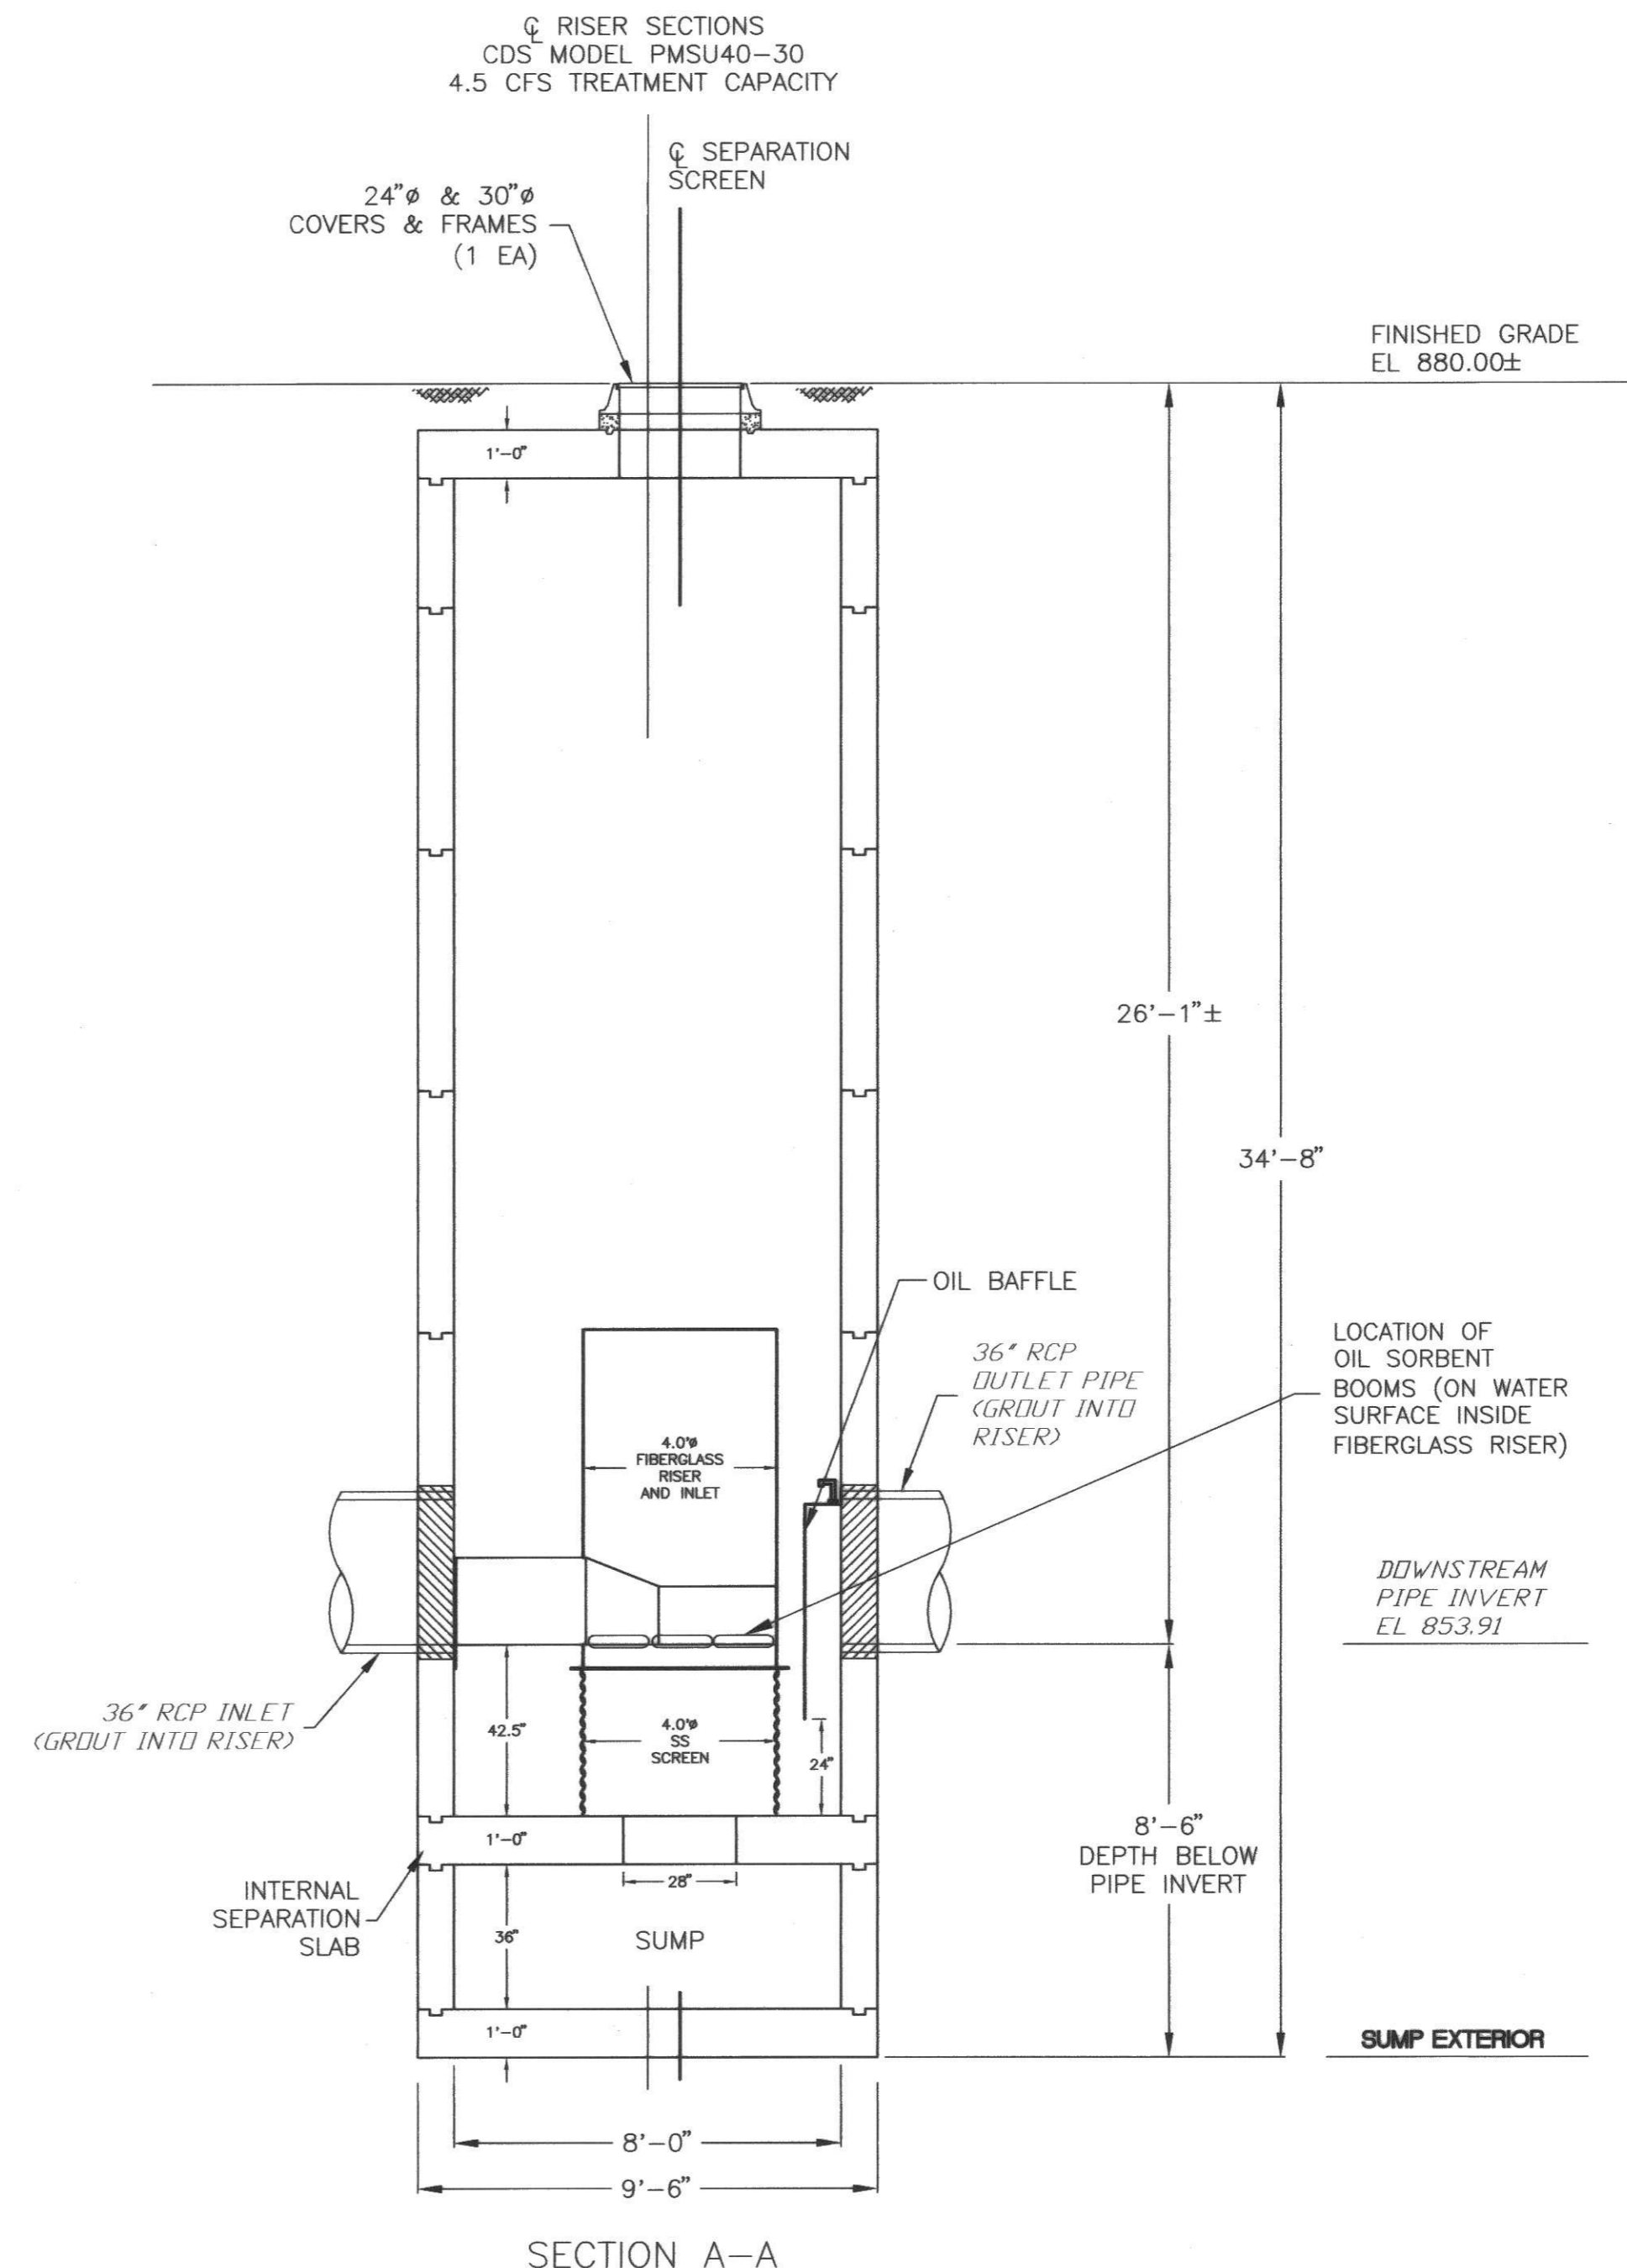

SECTION A-A

**CDS MODEL PMSU40\_30**  
**4.5 CFS CAPACITY**  
**STORM WATER TREATMENT UNIT**  
 (SEE SHEET NO. 15 FOR LOCATION)




AS-BUILT  
 11/26/12

**DIG ALERT**  
 SECTION 4216/4217 OF THE GOVERNMENT CODE  
 REQUIRES A DIGALERT IDENTIFICATION NUMBER  
 BE ISSUED BEFORE A "PERMIT TO EXCAVATE"  
 WILL BE VALID. FOR YOUR DIGALERT I.D. NUMBER  
 CALL UNDERGROUND SERVICE ALERT TOLL FREE  
 TWO WORKING DAYS BEFORE YOU DIG.  
 1-800-422-4133  
 CAUTION: REMEMBER THAT THE USA CENTER  
 NOTIFIES ONLY THOSE UTILITIES BELONGING TO  
 THE CENTER. THERE COULD BE OTHER UTILITIES  
 PRESENT AT THE WORK SITE. THE CENTER WILL  
 INFORM YOU OF WHOM THEY WILL NOTIFY.

**BENCHMARK**  
 BENCHMARK NO. = CG 3733  
 ELEVATION = 519.40 FT  
 ROAD DEPARTMENT TAG IN WESTERLY CURB 5  
 FEET SOUTH OF BCR, 78 FEET NORTH AND 42  
 FEET WEST OF CENTERLINE INTERSECTION OF  
 VALLEY BOULEVARD AND LEMON AVENUE.

Δ	DATE	DESCRIPTION	APP'D	DATE
REVISIONS				


CITY OF WALNUT  
 APPROVED BY: *David Gilbertson*  
 DAVID GILBERTSON  
 CITY ENGINEER - RCE 46624

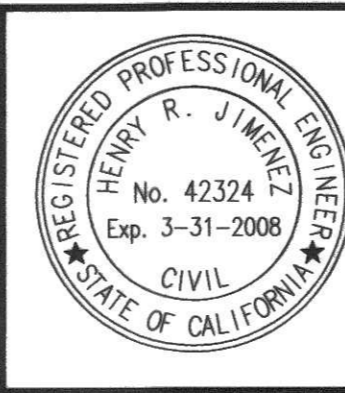


PREPARED BY:  
**MDS CONSULTING**  
 HENRY R. JIMENEZ  
 R.C.E. 42324  
 DATE: 10-17-06

**STORM DRAIN PLANS**  
 TRACT No. 50867  
**STORM DRAIN LINE "G"**  
 CDS MODEL PMSU40\_30  
 LOCATION 2  
 CITY OF WALNUT  
 187 V


SHEET  
 22  
 OF  
 24  
 SHEETS

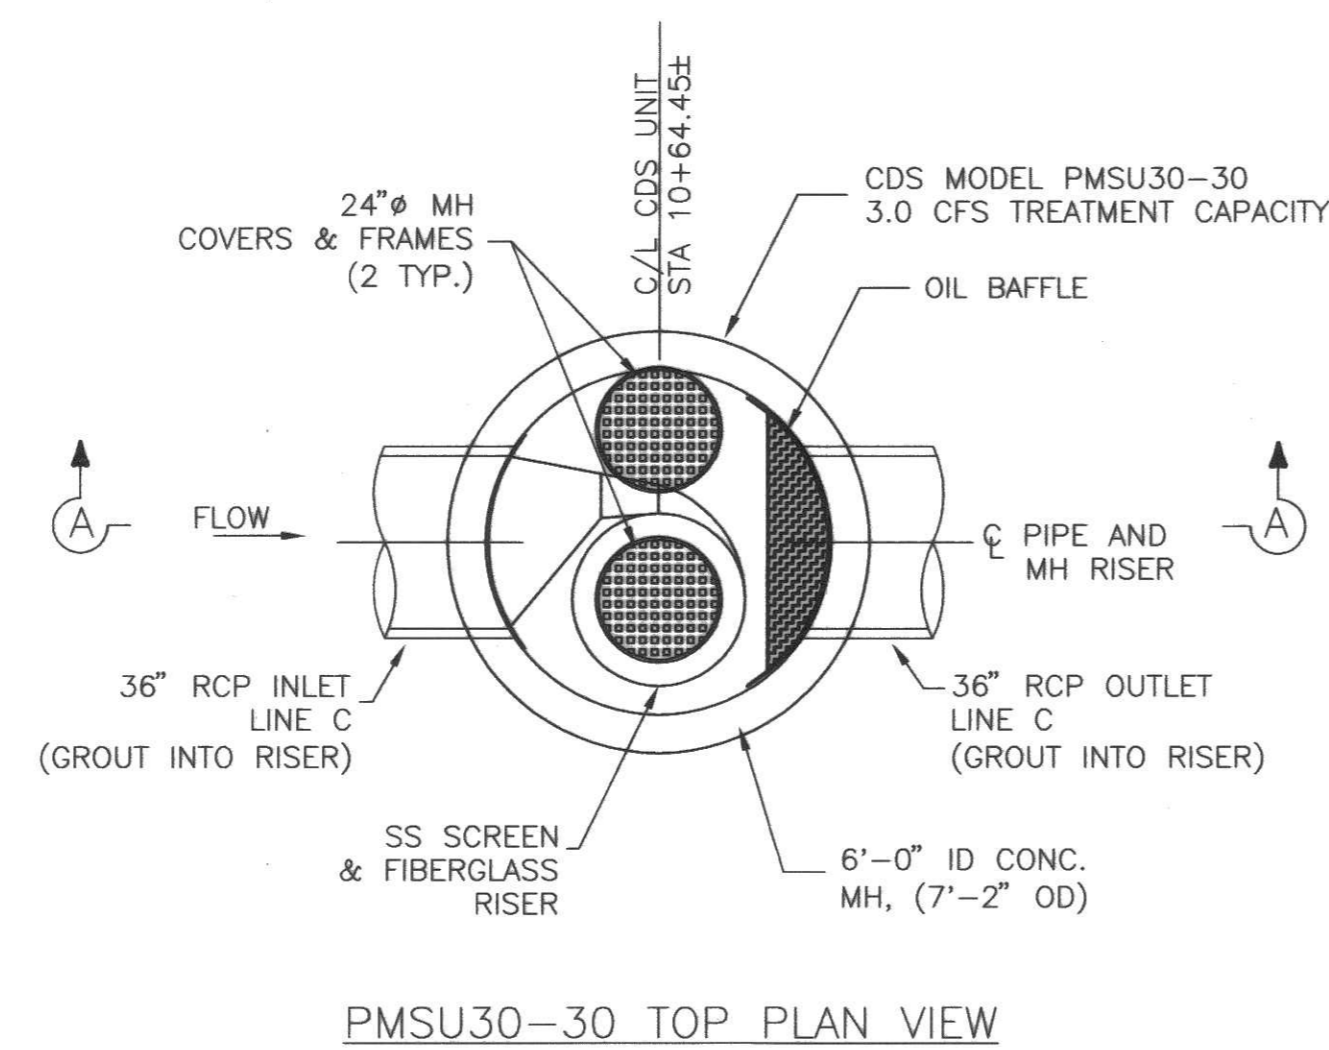

PMSU30-30 TOP PLAN VIEW

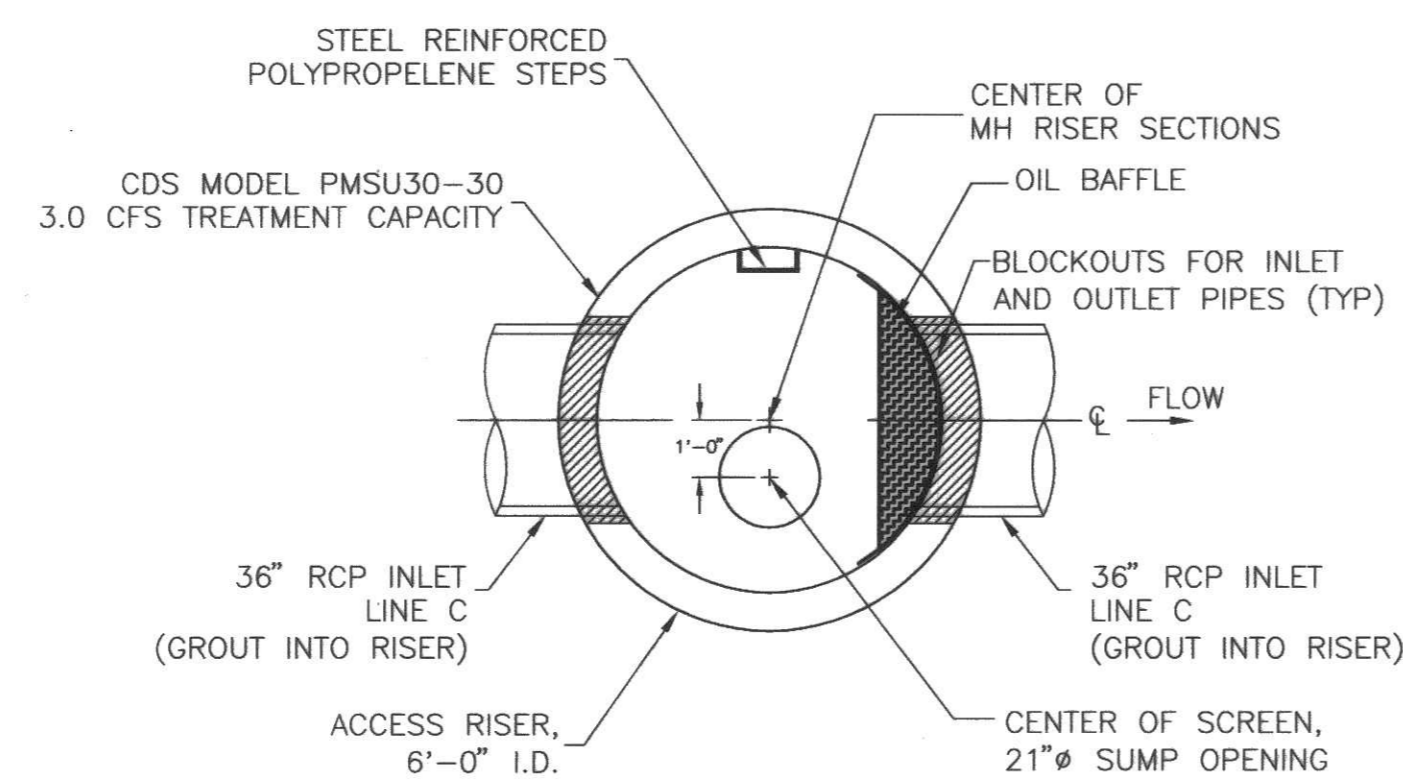

SEPARATION SLAB PLAN VIEW

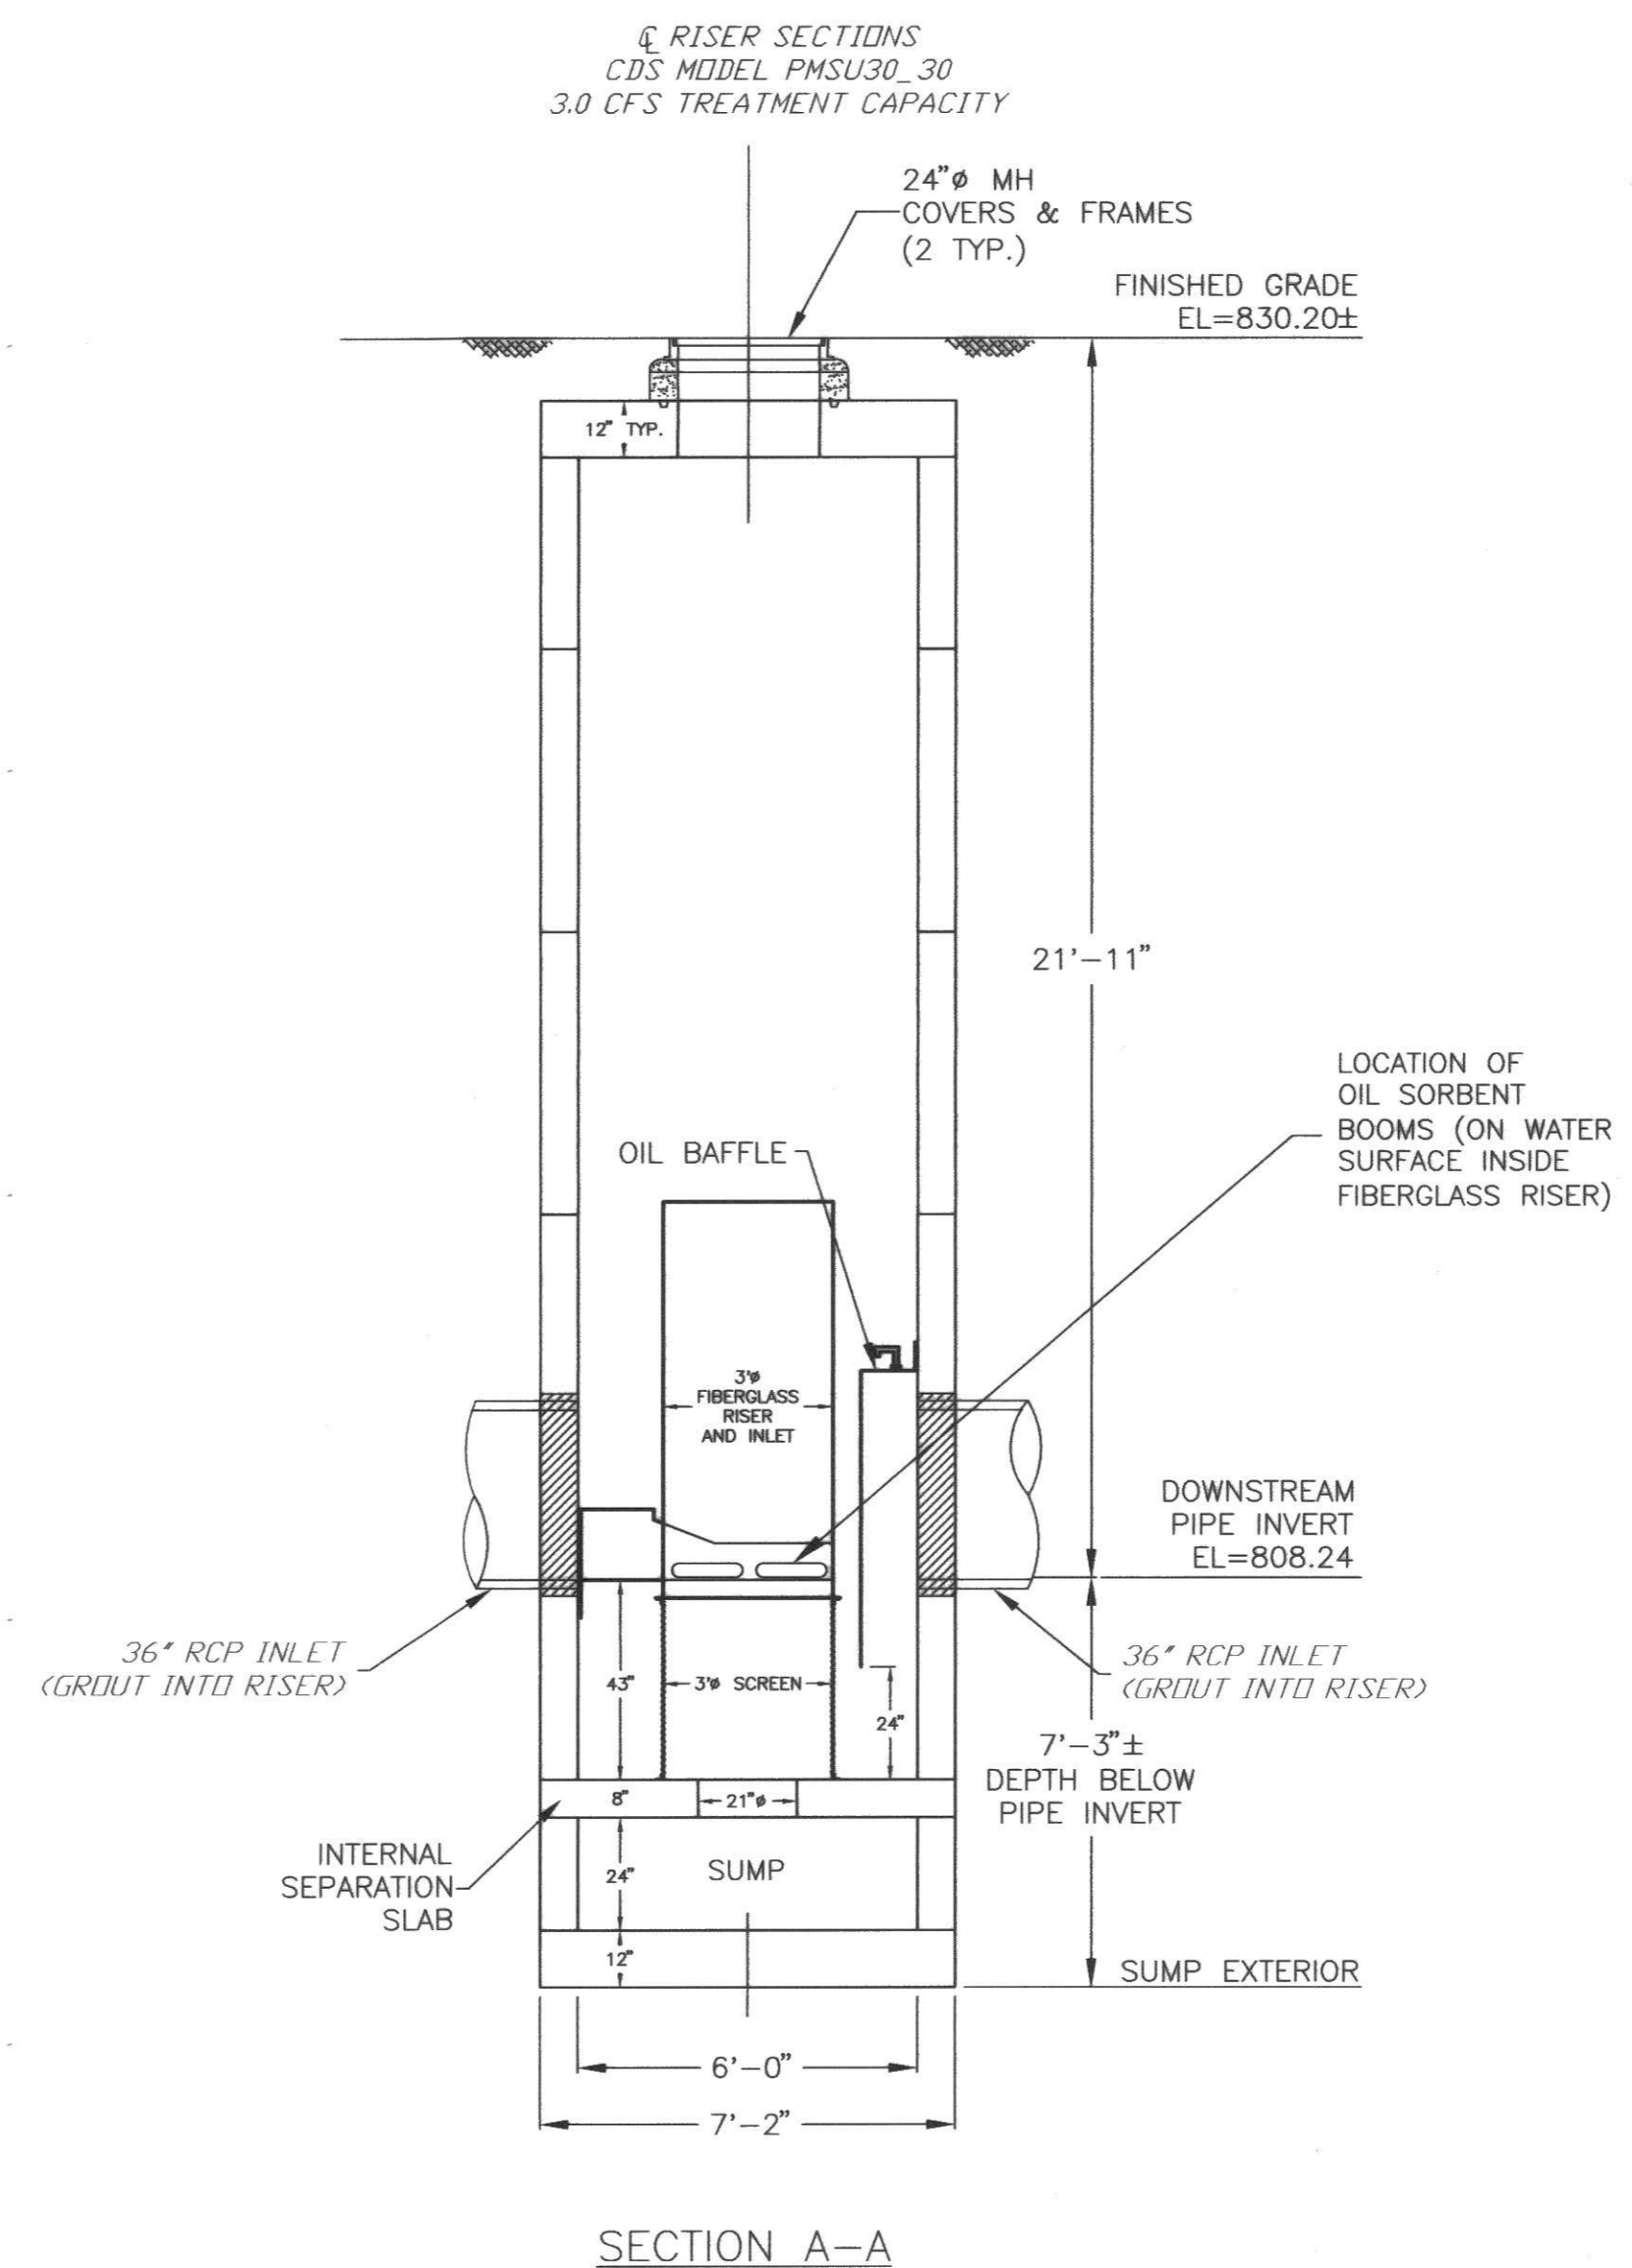


SECTION A-A

**CDS MODEL PMSU30\_30**  
**3.0 CFS CAPACITY**  
**STORM WATER TREATMENT UNIT**  
 (SEE SHEET NO. 14 FOR LOCATION)



AS-BUILT  
 11/26/12

**DIG ALERT**

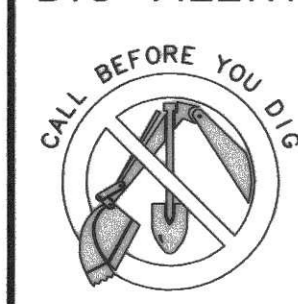

SECTION 4216/4217 OF THE GOVERNMENT CODE REQUIRES A DIGALERT IDENTIFICATION NUMBER BE ISSUED BEFORE A "PERMIT TO EXCAVATE" WILL BE VALID. FOR YOUR DIGALERT I.D. NUMBER CALL UNDERGROUND SERVICE ALERT TOLL FREE TWO WORKING DAYS BEFORE YOU DIG.  
 1-800-422-4133  
 CAUTION: REMEMBER THAT THE USA CENTER NOTIFIES ONLY THOSE UTILITIES BELONGING TO THE CENTER. THERE COULD BE OTHER UTILITIES PRESENT AT THE WORK SITE. THE CENTER WILL INFORM YOU OF WHOM THEY WILL NOTIFY.


**BENCHMARK**

BENCHMARK NO. = CG 3733  
 ELEVATION = 519.40 FT  
 ROAD DEPARTMENT TAG IN WESTERLY CURB 5 FEET SOUTH OF BCR, 78 FEET NORTH AND 42 FEET WEST OF CENTERLINE INTERSECTION OF VALLEY BOULEVARD AND LEMON AVENUE.

Δ	DATE	DESCRIPTION	APP'D	DATE
REVISIONS				

**CITY OF WALNUT**

APPROVED BY: *David Gilbertson*  
 DAVID GILBERTSON  
 CITY ENGINEER - RCE 46624  
 DATE: 10/19/06

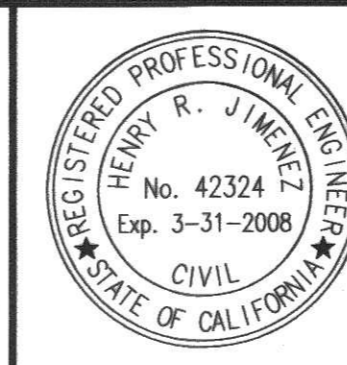

**PREPARED BY:**


**MDS CONSULTING**  
 PLANNERS ENGINEERS SURVEYORS  
 HENRY R. JIMENEZ  
 R.C.E. 42324  
 DATE: 10-19-06

**STORM DRAIN PLANS**


TRACT No. 50867  
**STORM DRAIN LINE "C"**  
 CDS MODEL PMSU30\_30  
 LOCATION 3  
 CITY OF WALNUT

187W


SHEET  
**23**  
 OF  
**24**  
 SHEETS

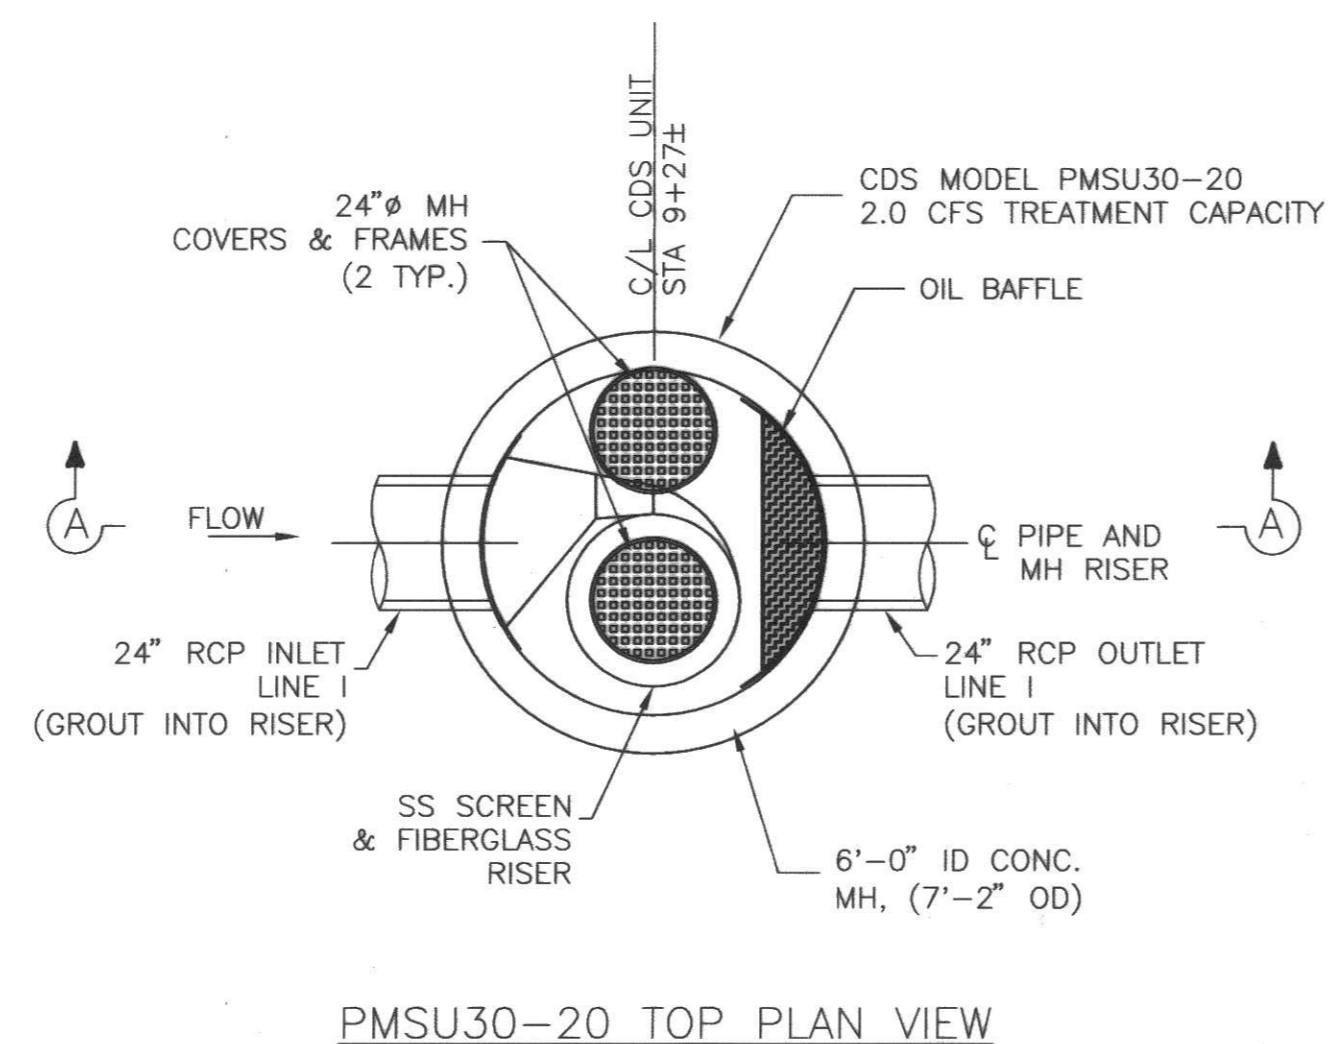

PMSU30-20 TOP PLAN VIEW

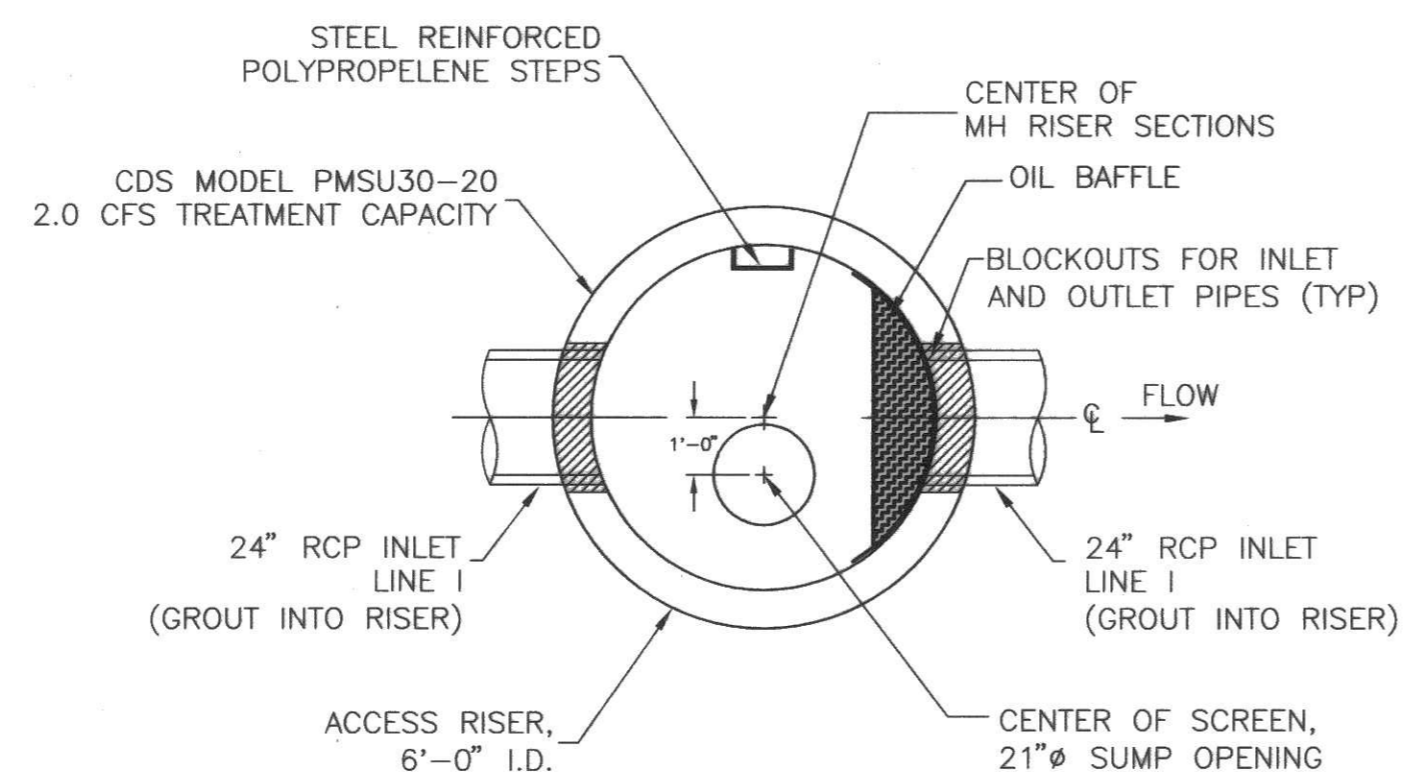

SEPARATION SLAB PLAN VIEW

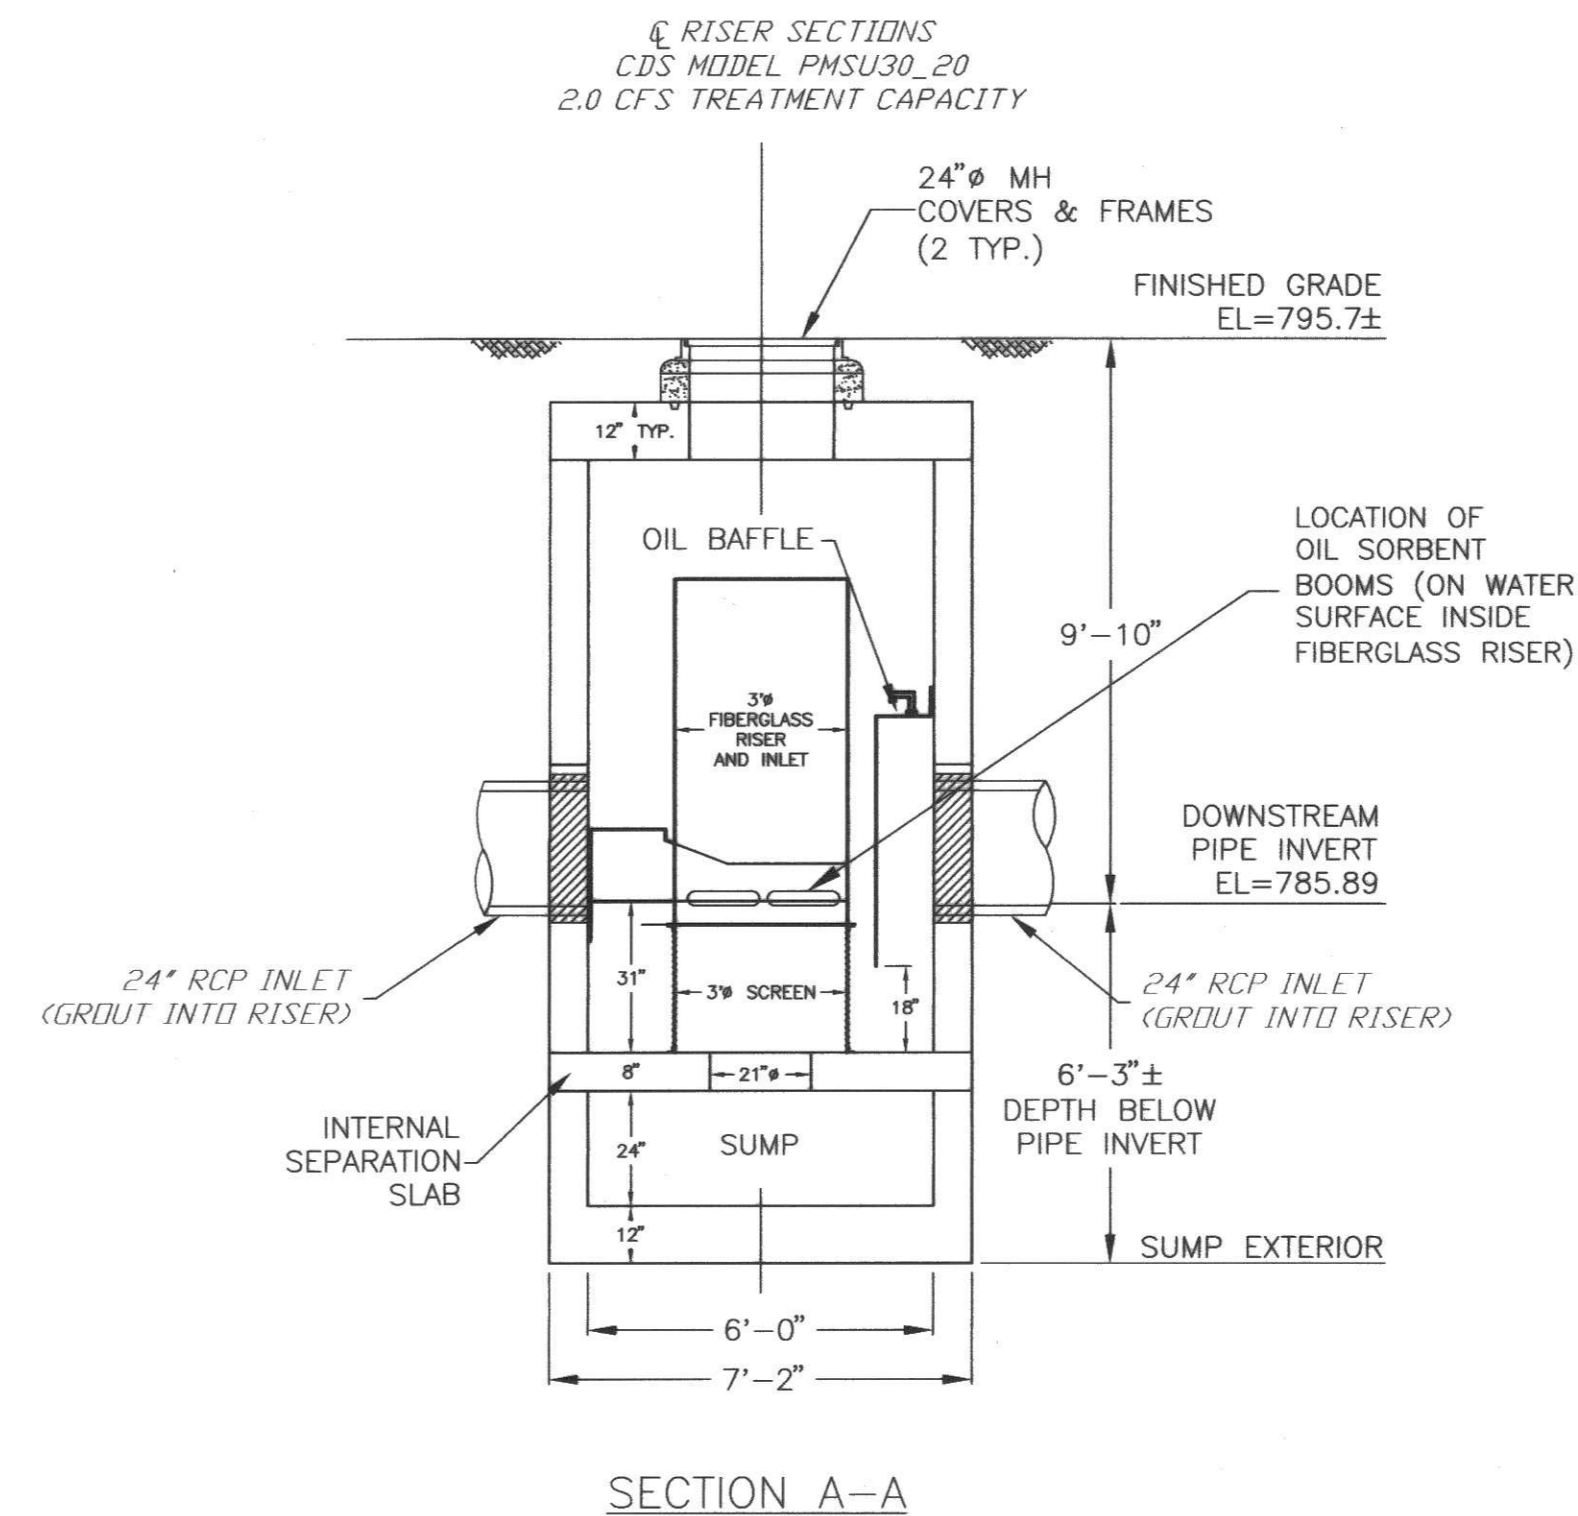

SECTION A-A

**CDS MODEL PMSU30\_20**  
**2.0 CFS CAPACITY**  
**STORM WATER TREATMENT UNIT**  
 (SEE SHEET NO. 16 FOR LOCATION)



AS-BUILT  
 11/26/12

**DIG ALERT**  
 SECTION 4216/4217 OF THE GOVERNMENT CODE REQUIRES A DIGALERT IDENTIFICATION NUMBER BE ISSUED BEFORE A "PERMIT TO EXCAVATE" WILL BE VALID. FOR YOUR DIGALERT I.D. NUMBER CALL UNDERGROUND SERVICE ALERT TOLL FREE TWO WORKING DAYS BEFORE YOU DIG.  
 1-800-422-4133  
 CAUTION: REMEMBER THAT THE USA CENTER NOTIFIES ONLY THOSE UTILITIES BELONGING TO THE CENTER. THERE COULD BE OTHER UTILITIES PRESENT AT THE WORK SITE. THE CENTER WILL INFORM YOU OF WHOM THEY WILL NOTIFY.

**BENCHMARK**  
 BENCHMARK NO. = CG 3733  
 ELEVATION = 519.40 FT  
 ROAD DEPARTMENT TAG IN WESTERLY CURB 5 FEET SOUTH OF BCR, 78 FEET NORTH AND 42 FEET WEST OF CENTERLINE INTERSECTION OF VALLEY BOULEVARD AND LEMON AVENUE.

Δ	DATE	DESCRIPTION	APP'D	DATE
<b>REVISIONS</b>				

CITY OF WALNUT  
 APPROVED BY: *David Gilbertson* 10/26/06  
 DAVID GILBERTSON DATE  
 CITY ENGINEER - RCE 46624



PREPARED BY:  
**MDS CONSULTING**  
 HENRY R. JIMENEZ R.C.E. 42324 DATE 10-19-06

**STORM DRAIN PLANS**  
 TRACT No. 50867  
**STORM DRAIN LINE "T"**  
 CDS MODEL PMSU30\_20  
 LOCATION 4  
 CITY OF WALNUT

SHEET  
**24**  
 OF  
**24**  
 SHEETS